


Completed 12-7-17.

— V. R. —

— YABBA NORTH —

— Signalling Arrangements —

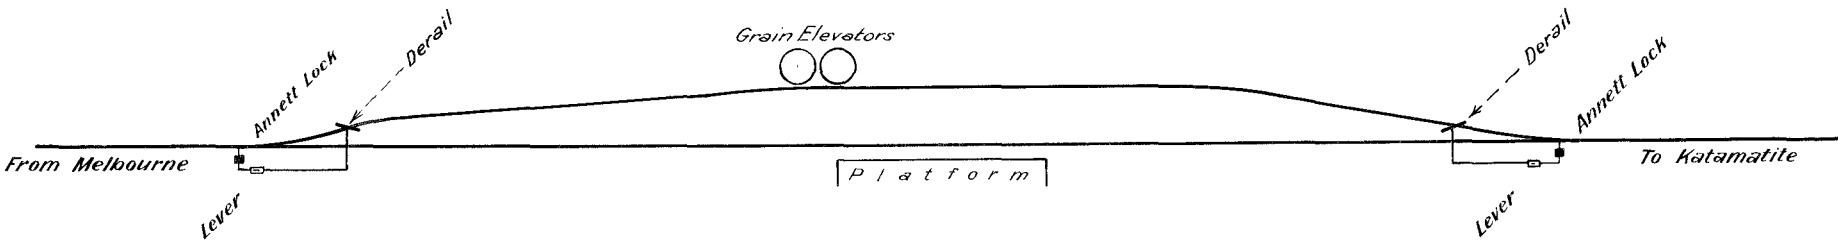

F416

RECORD PLAN
R 303
NEW SOUTH
WALES
17/11/37