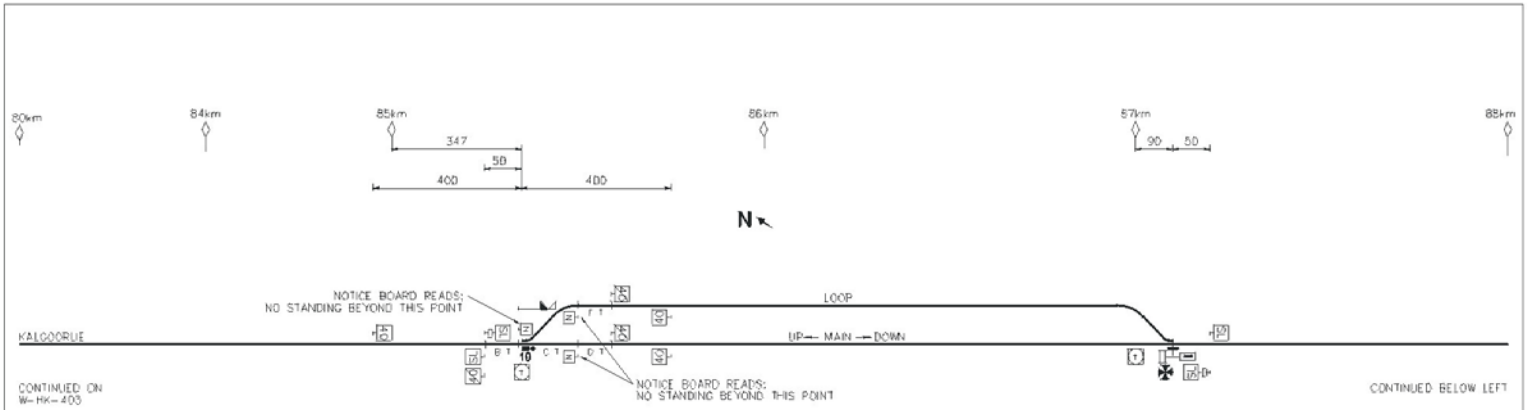

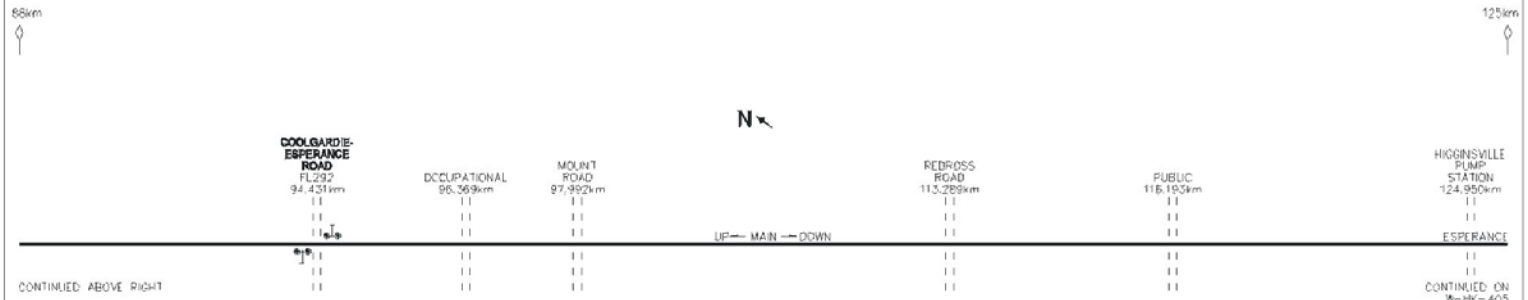

STANDING ROOM	
MAIN	1485
LOOP	1485

SYMBOLS SHOWN ON DRAWING W-80
ALL DIMENSIONS IN METRES

AMENDMENT PREPARATION			
DATE	DSN	CKD	APP
D 17 NOV 05	KK		
C 4 OCT 05	KK		
B 15 JUN 05	APP		
A 7 JAN 05	KK		

DRAWING PREPARATION			
DATE DRAWN		DATE APPROVED	
17 AUG 01		28 FEB 94	
DSN	DRN	CKD	APP
AM	MJK	MC	SE

DATE COMMISSIONED	
AS BUILT DRAWING	

LEFROY

STATION SKETCH

SECTION 51 – 80km to 125km

WestNetRail Control and Communications Systems

Job Number 8g242

ISSUE LIST	CIRCUIT BOOK	SHEET NUMBER
.	8	51-5

W-HK-404 Rev. D